
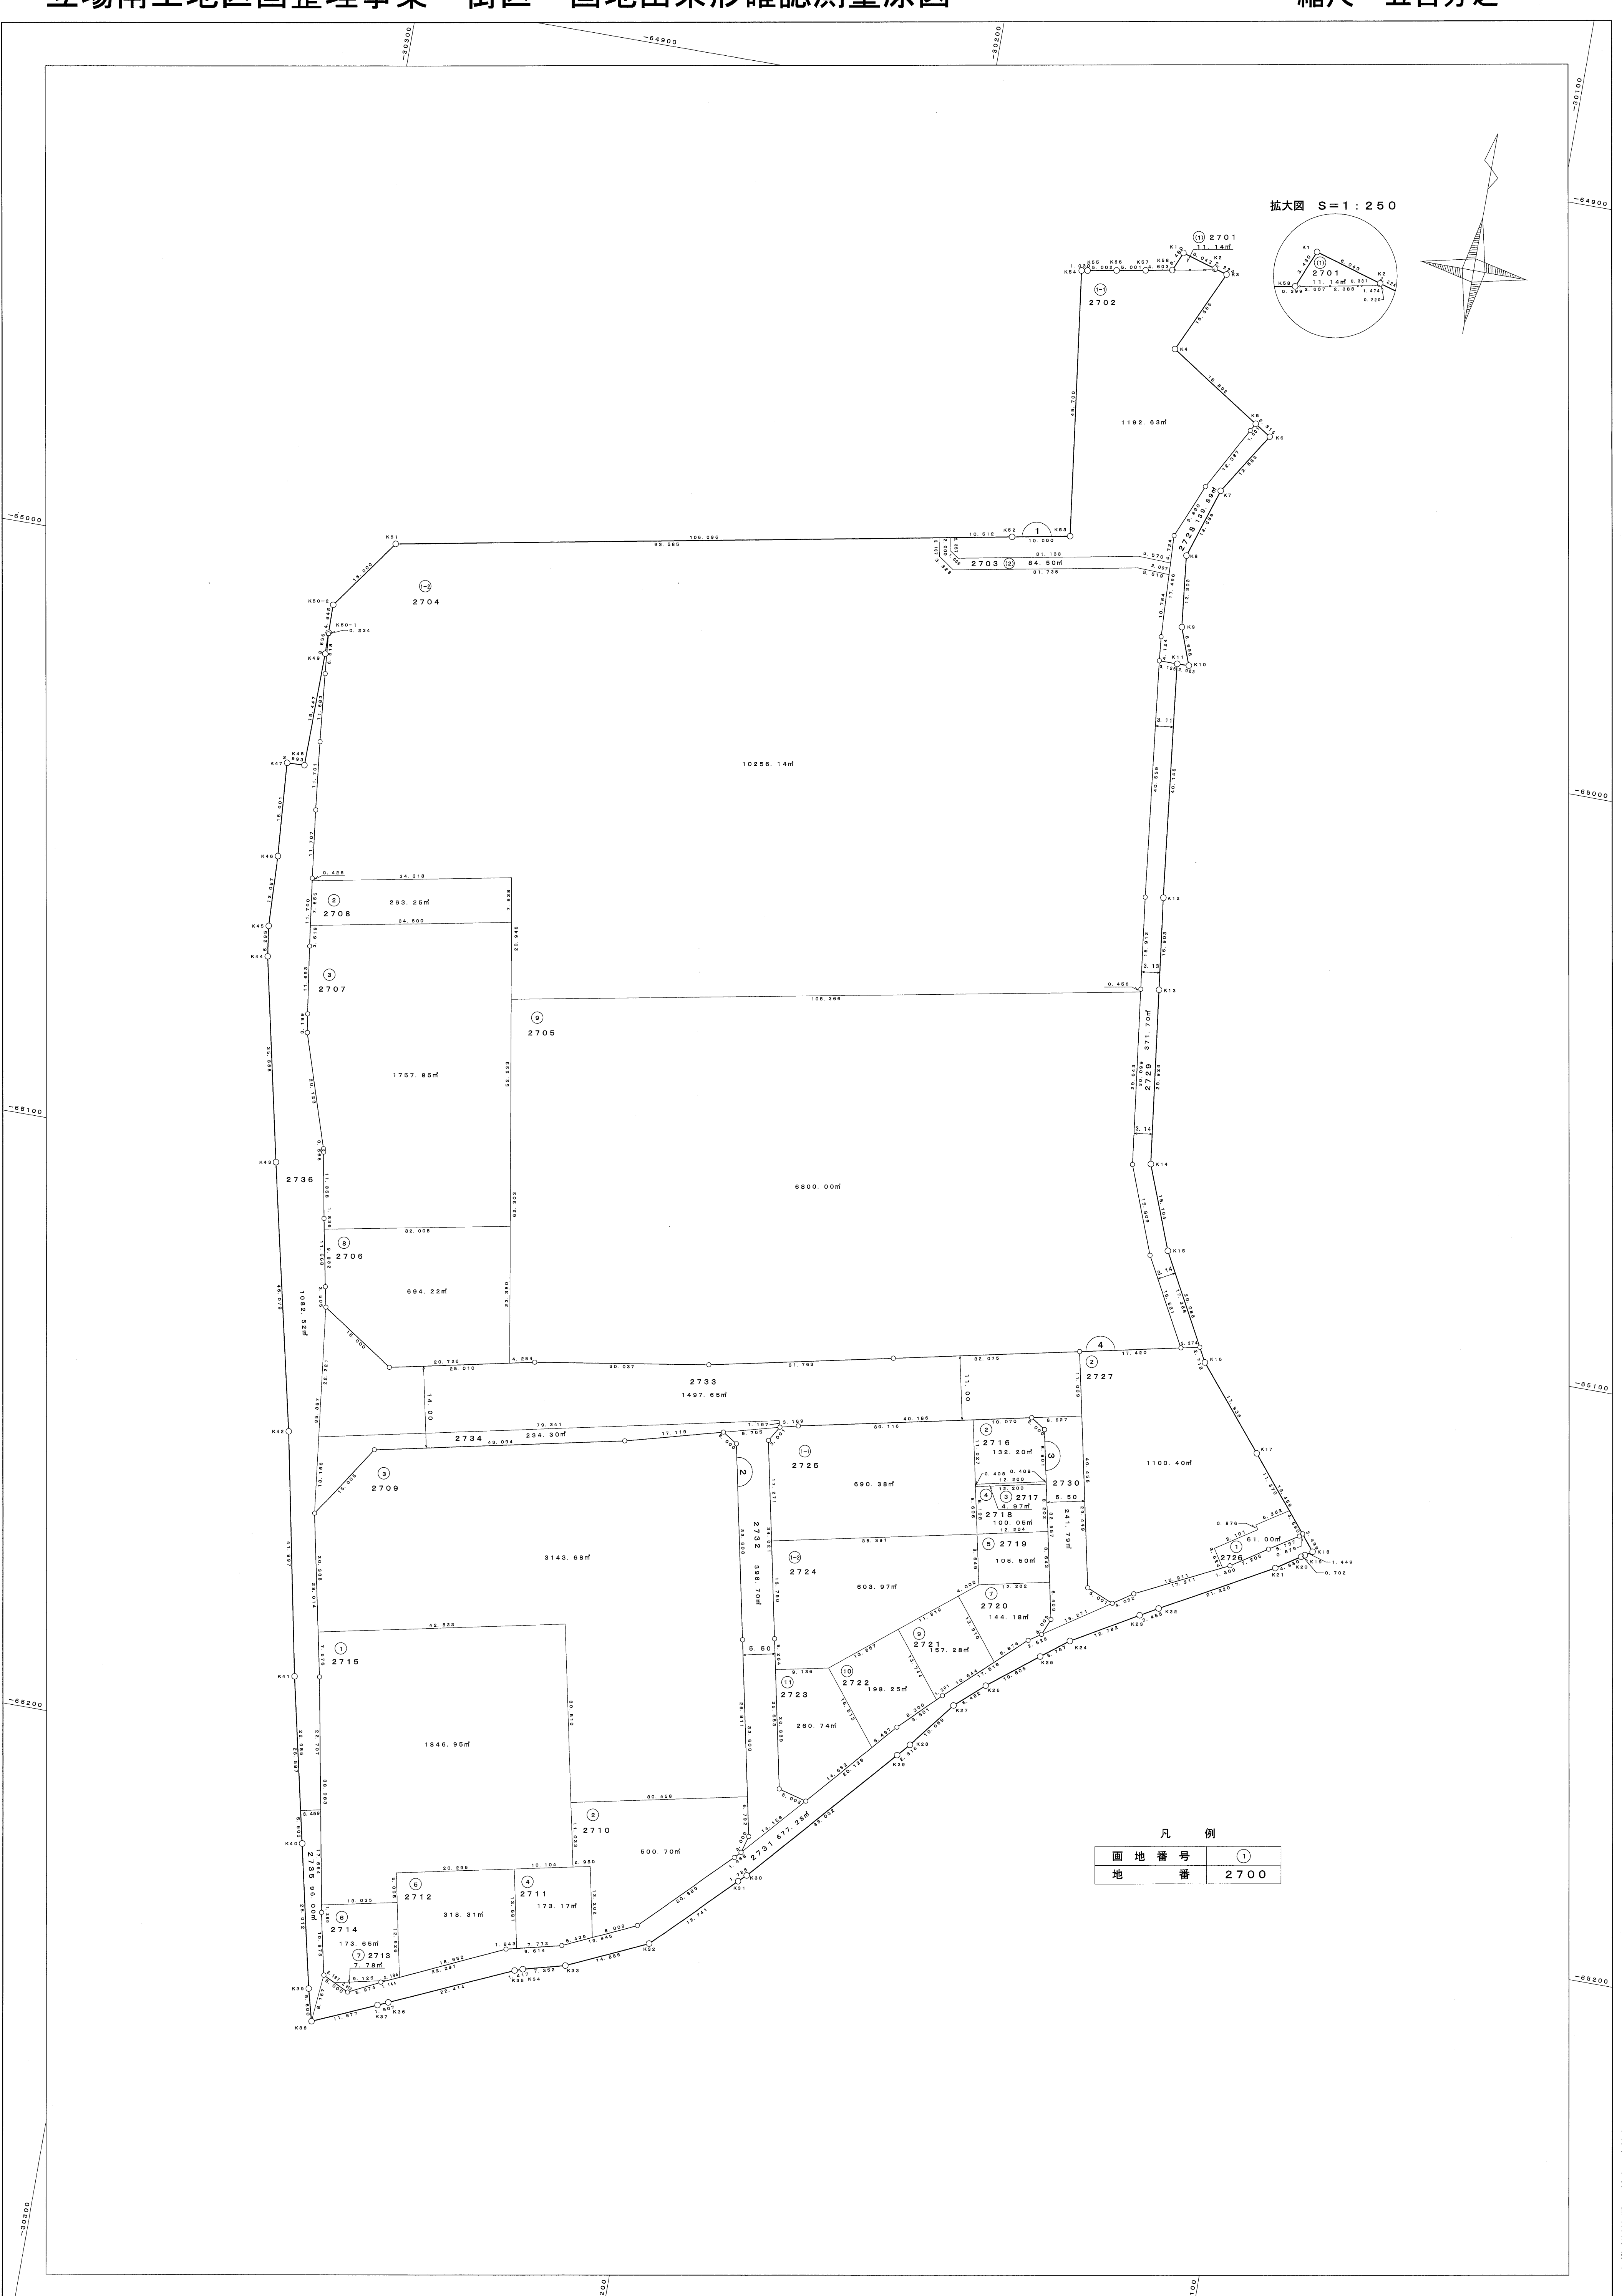
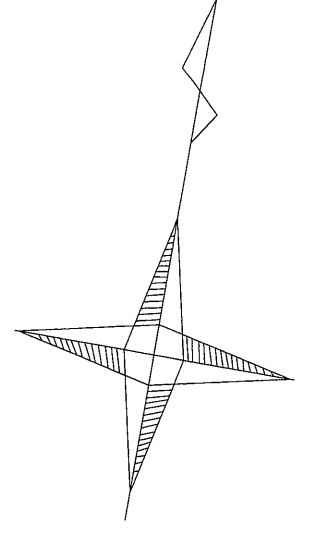


平成十六年一月

拡大図 S=1:250

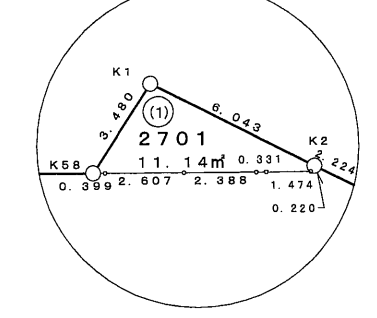

凡例

画地番号	①
地番	2700